


CITY PLACE

CITYPLACE 3 SUITE 1060

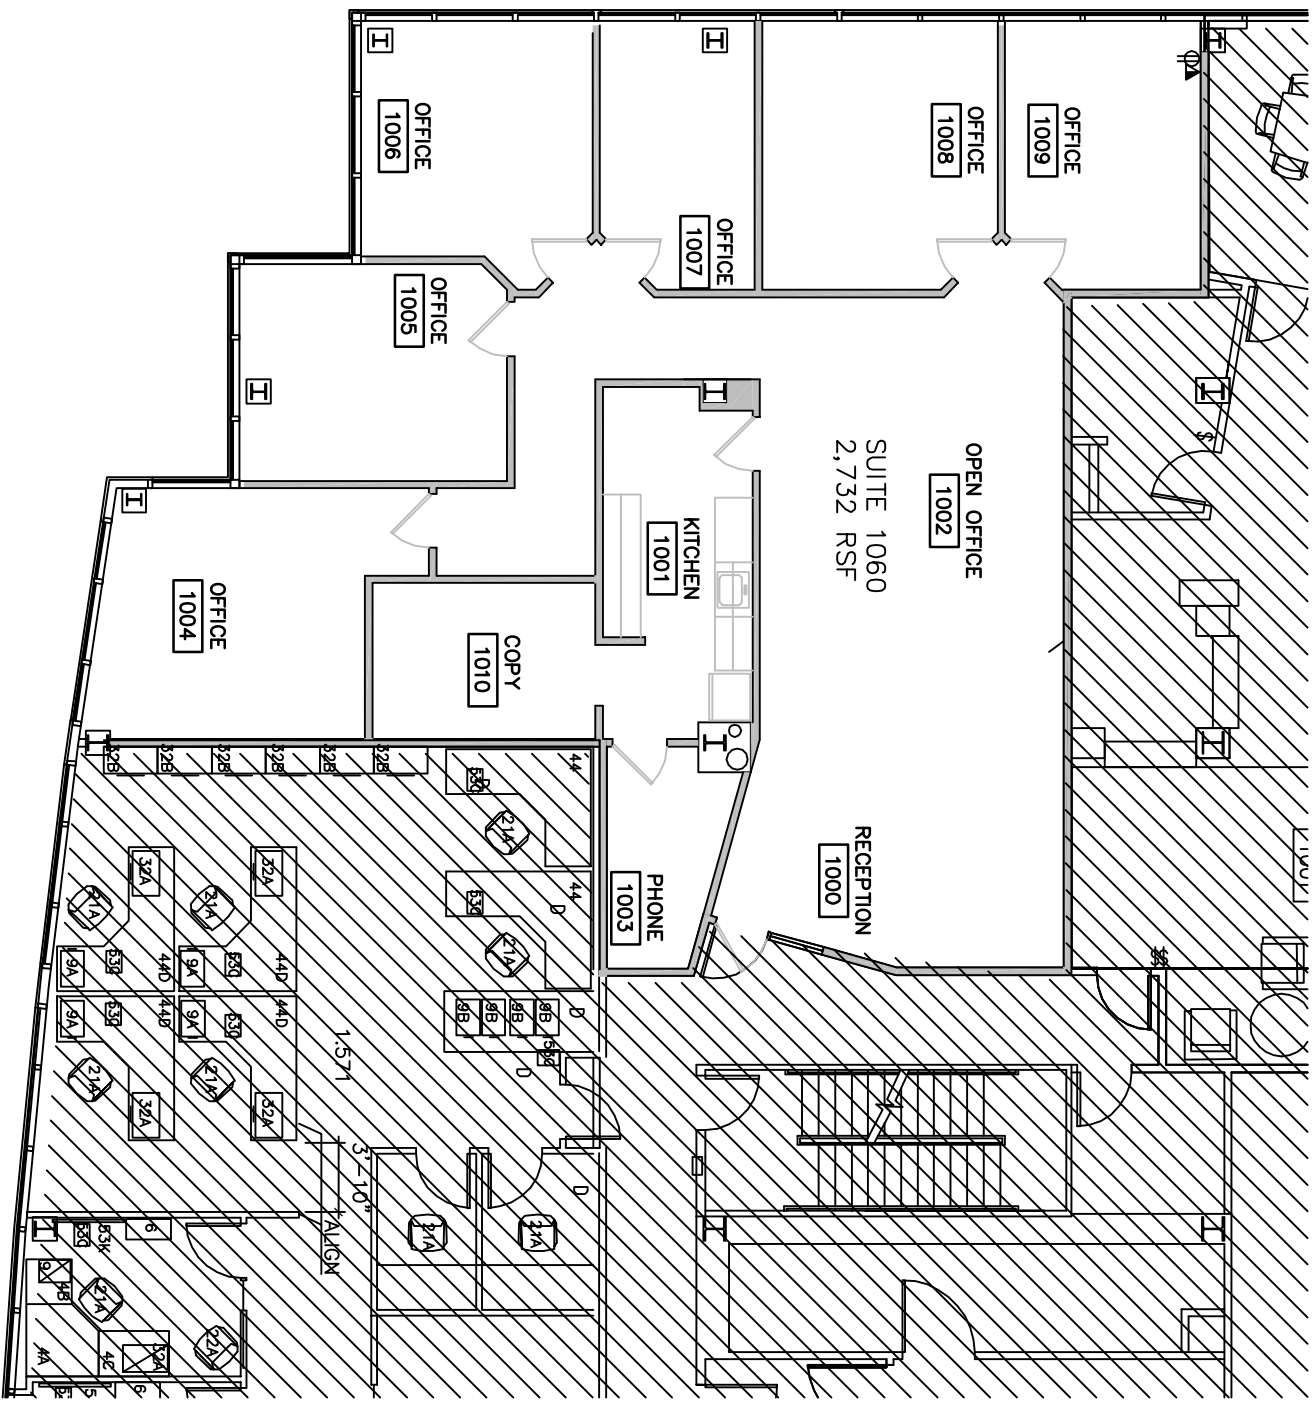

PROJECT NAME: CITYPLACE 3, SUITE 1060
 LOCATION: CITY PLACE 3, 10TH FLOOR
 RENTABLE AREA: 2,732 RSF
 SCALE: 3/32" = 1'-0"
 ISSUE DATE: 10/07/13



THE KOMAN GROUP
 SIX CITYPLACE DRIVE
 SUITE 1060
 ST. LOUIS, MO 63141
 T 314.993.5800



THE KOMAN GROUP

ARCTURIS
 720 OLIVE STREET
 SUITE 200
 ST. LOUIS, MO 63101
 T 314.206.7100

ARCTURIS
 720 OLIVE STREET
 SUITE 200
 ST. LOUIS, MO 63101
 T 314.206.7100